


# BILL OF MATERIALS

ITEM QTY.	DESCRIPTION	MAT'L	REMARKS	O / B	REQ. / PA

- NOT APPLICABLE
- 1 WPS No 5AW-97
- 2 WPS No FC 03
- 3 WPS No M-10

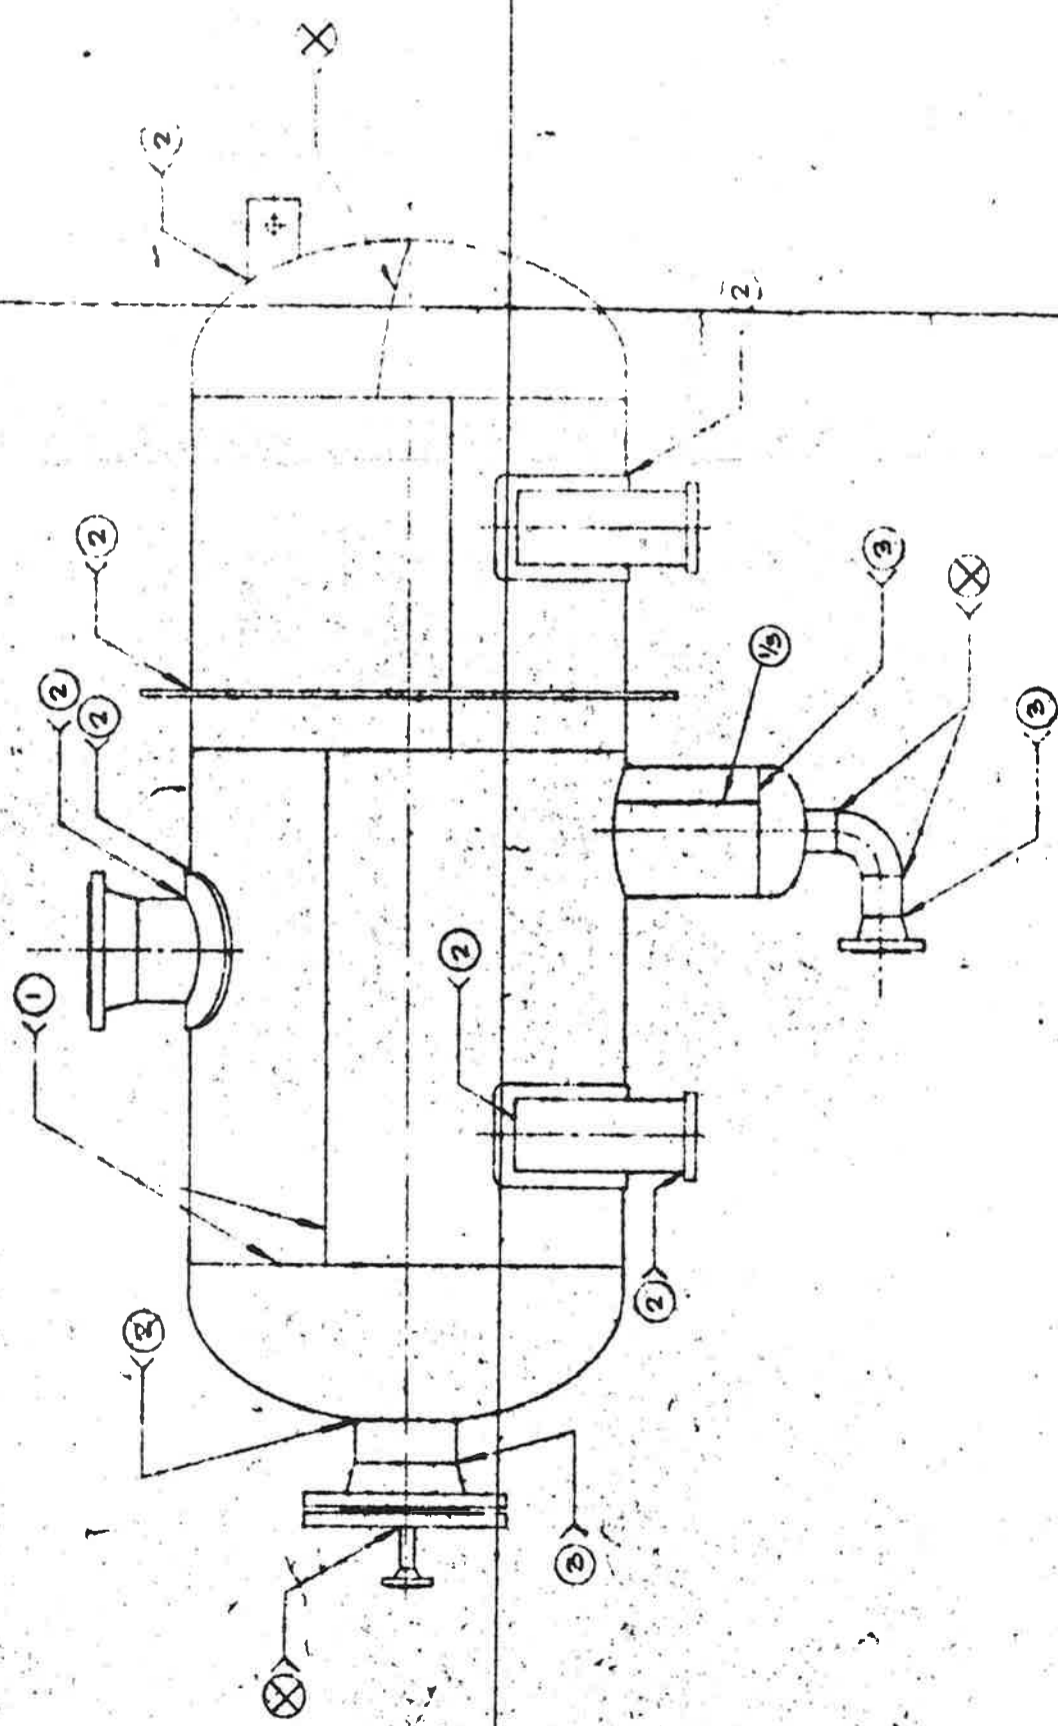

831112

**APPROVED**  
NO RESPONSIBILITY ASSUMED FOR  
ACCURACY OF SHOP DIMENSIONS  
FISH INTERNATIONAL

CERTIFIED AS BUILT  
*Jh*

FISH INTERNATIONAL  
SERIAL NO 8301-412-34  
ITEM NO. V-820ARC

831110

**STRATHCONA STEEL MFG. INC.**  
9303 - 81 AVENUE EDMONTON, ALBERTA (403) 434-8437

CUSTOMER FISH INTERNATIONAL  
CUSTOMER P.O. 8301-412 TAG NO. V-820-A,B,C

3050 I.D. LPG STORAGE BULLETS

WELD MAP

BY	DATE	APP'D	DATE	DESCRIPTION

OWN. <i>Carl</i>	DATE JUNE 1985	JOB NO 83-725	DWG NO. C-3125-IC	REV. 0
APP. /	DATE /			